



Revision
Date: 12/20/24

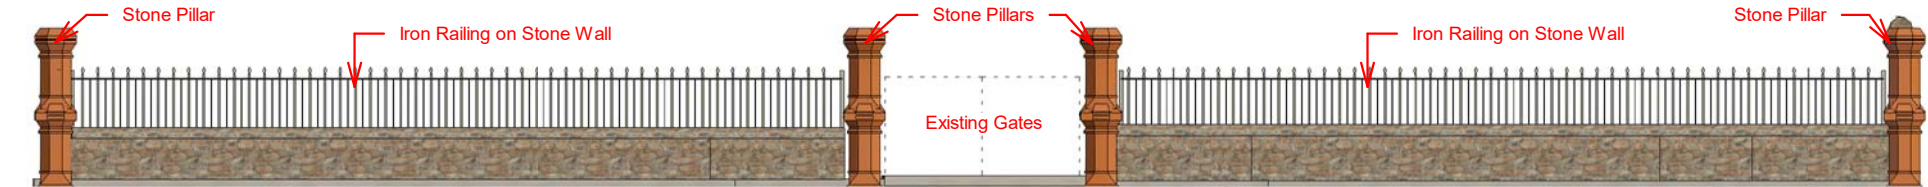

1 Existing Boundary Frontage
1 : 100

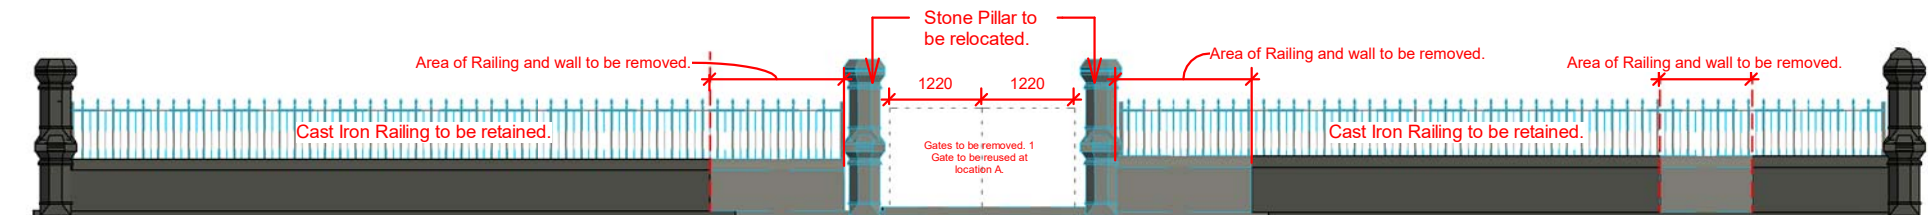


3 Proposed Boundary Frontage - Demo
1 : 100

If railing has to be altered section marked in red to be removed. This will maintain the railing pattern, structure & decor high points.



Proposed alterations to railings will be done in sections to maintain a high quality standard of finish for the listed property within the conservation area. Please see above photo for plan to alter railings.

Railing sections to be altered for the pedestrian & Vehicle access, widths will be determined by the width of each cast iron railing section (Photo above for Ref).

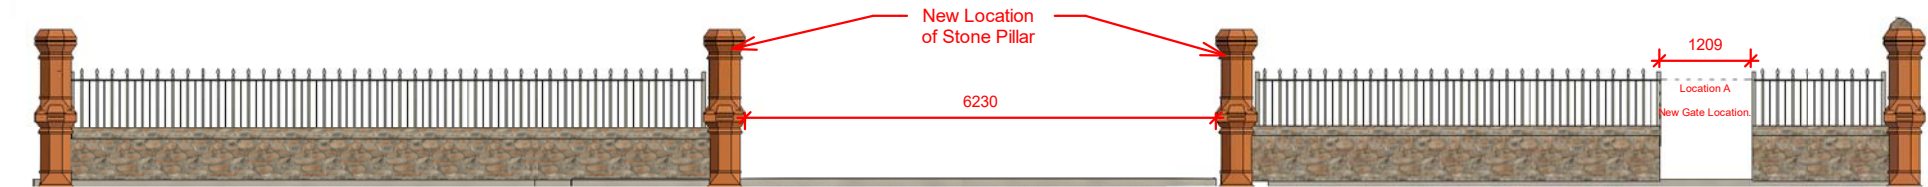

2 Proposed Boundary Frontage
1 : 100





ANGUS
DESIGN
ASSOCIATES LTD

Proposed Boundary Wall
Alterations

Drawing No: AL013
Scale (A3): 1 : 100

Planning

All sizes dimensions and heights are to be checked on site and confirmed before work commences. Sites sizes take preference to scaled sizes